


REDLINED SHEET

FIG. 1
PRIOR ART

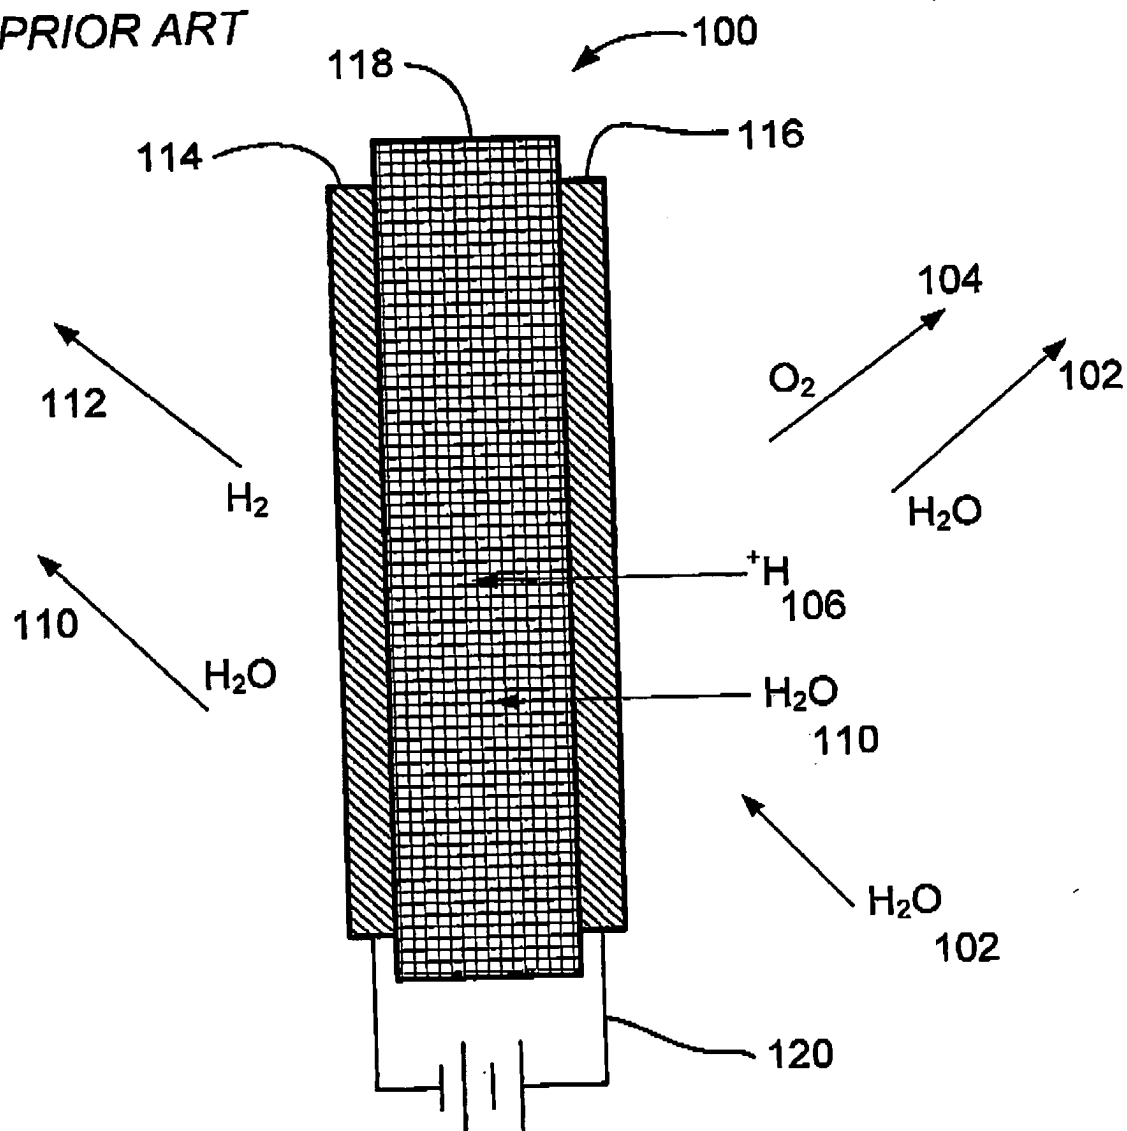

REPLACEMENT SHEET

FIG. 1
PRIOR ART

